
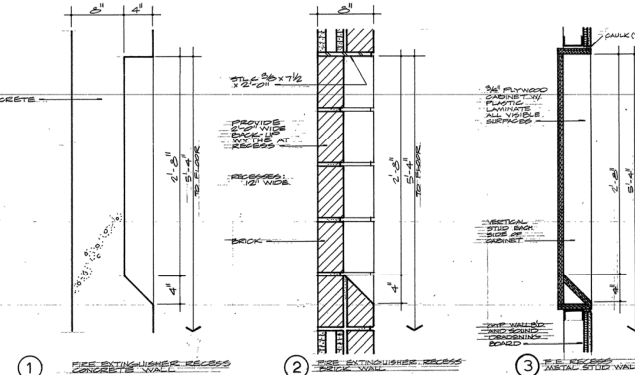


TOILET ACCESSORY SCHEDULE			
KEY	DESCRIPTION	MOUNT'G HT TO TOP	REMARKS
NOTE: SEE SPEC'S. FOR DETAILED DESCRIPTIONS			
A	MULTIPURPOSE UNIT	6'-1"	
B	WASTE RECEPTACLE	3'-4"	
C	GRAB BAR	2'-0"	
D	TOILET TISSUE DISPENSER	3'-11"	MOUNT AT 5'-0" HIGHER CAPPED STALLS
E	FEMININE NAPKIN DISPOSAL UNIT	2'-3"	

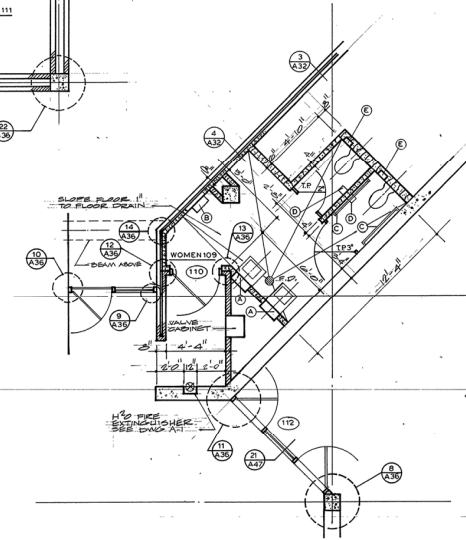

PLAN 735 LEVEL 1/8^{II}
 FINISH FLOOR ELEVATION 736.33

	FLOOR PLAN 735 LEVEL Academic Services Building Kentucky State University Frankfort, Kentucky
	Commonwealth of Kentucky Executive Department for Finance & Administration Bureau of Facilities Management Division of Engineering, Frankfort, Kentucky
AS-BUILT <i>Maurice Blakeman</i>	G. Maurice Blakeman Associates, Architects P.O. Box 907, Versailles Road Frankfort, Kentucky 40601
Approved for Program Concept Only <i>W. J. McCallum</i> Chief Architect, Div. Of Eng.	Approved for Program Only <i>W. J. McCallum</i> Approved for Program Only